

**LONDON BOROUGH OF CAMDEN
TOWN AND COUNTRY PLANNING ACT 1990
SECTION 247
GREATER LONDON AUTHORITY ACT 1999**

**THE STOPPING UP OF HIGHWAYS
(LONDON BOROUGH OF CAMDEN) (NUMBER 3) ORDER 2017
MADE: 11 May 2018**

PART OF CHESTER GATE

The London Borough of Camden makes this order in the exercise of its powers under Section 247 of the Town and Country Planning Act 1990 as amended by Section 270 and Schedule 22 of the Greater London Authority Act 1999 and of all other enabling powers: -

The London Borough of Camden authorises the stopping up of the area of highway described in the First Schedule to this Order and shown on the attached drawing number 2031/004/A, solely in order to enable the development described in the Second Schedule to this order to be carried out in accordance with the planning permission granted under Part III of the Town & Country Planning Act 1990, by the Secretary of State for Communities and Local Government on the 19 May 2017 under appeal reference APP/X5210/W/16/3162987 (Camden reference 2016/1479/P).

1. This Order shall come into force on 17 May 2018 and may be cited as the Stopping Up of Highways (London Borough of Camden) (Number 3) Order 2017.

**THE COMMON SEAL OF THE MAYOR)
AND BURGESSES OF THE LONDON)
BOROUGH OF CAMDEN was hereunto)
Affixed by Order:-)**



P. Alexander

.....
Authorised Signatory

COPY

THE FIRST SCHEDULE

Areas of highway to be Stopped Up

- Footway and part of carriageway on the south side of Chester Gate an area 42.8m long by 8.7m wide from the junction of Outer Circle (back of footpath) as shown hatched on drawing 2031/004/A.

THE SECOND SCHEDULE

The Location of the Development

- Land at Chester Gate adjacent to Nos. 6-10 Cambridge Terrace London NW1 4JL

The Development

- Reinstatement of historic garden on Chester Gate, and associated works

COPY

NOTES

1. Do not scale from this drawing.
2. This drawing to be read & printed in colour.
3. This drawing is for illustrative purposes only.

KEY:

- PROPOSED KERB LINE
- AREA TO BE STOPPED UP [323sqm]
- EXISTING KERB LINE
- EXISTING BACK EDGE OF FOOTWAY
- TERMINAL POINTS

A, B, C & D

MEASUREMENTS

A to B	=	42.80m
C to D	=	8.70m

REVISION HISTORY

Rev	Details	AS	GS	29.06.2017	Drawn	Checked	Date
A	Amendments to detail						

Status: Preliminary For Approval For Construction
 For Information For Tender As Built

Client: _____

Project: **Chester Gate Garden**


Drawing Title: **Highway Layout and Stopping Up Plan**

Scale: 1:250 Checked by: GS Date: 12.06.17 Size: A3

Drawn by: AS

CANEPARO ASSOCIATES
 Transport Planning & Highway Design
 21 Little Portland Street • London • W1W 8BT • Tel: 020 3617 8200

Scheme Ref: **2031** Drawing No: **004** Rev: **1 of 1** A

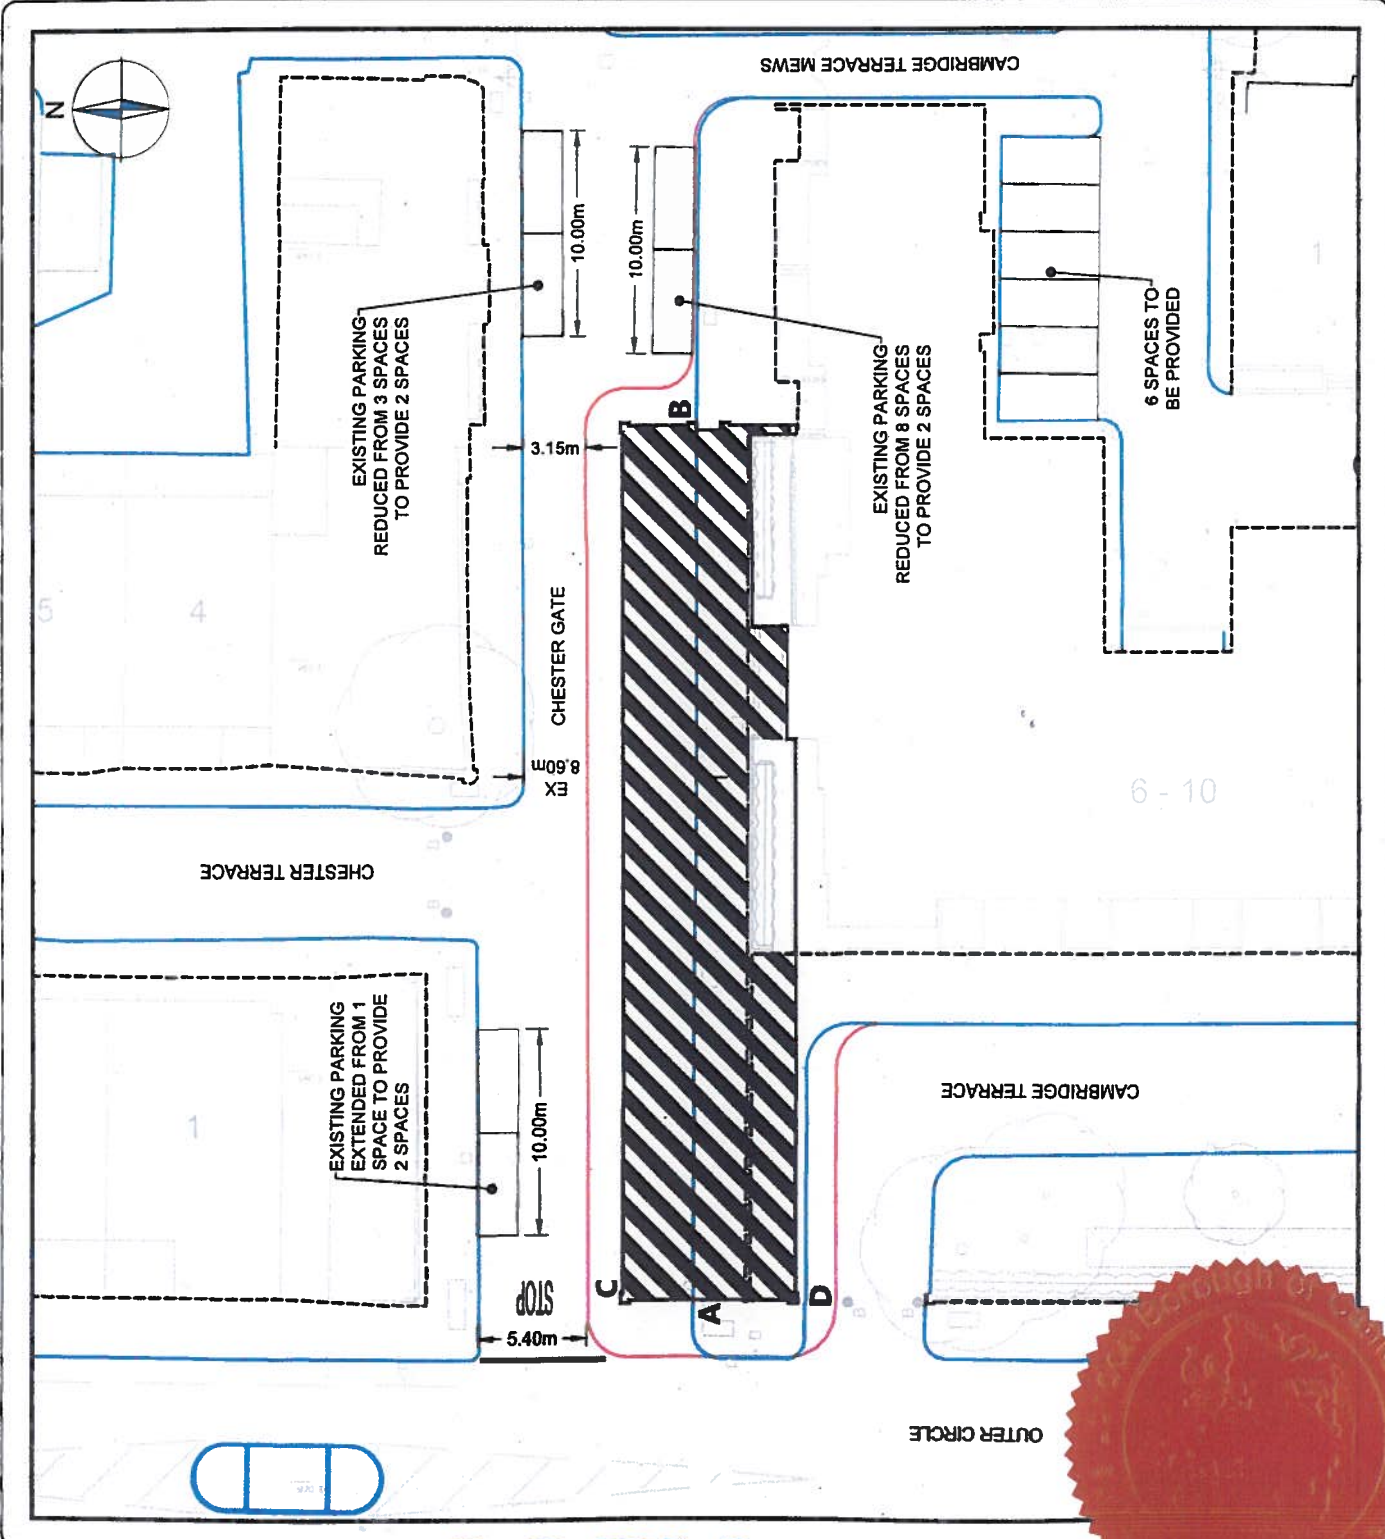

COPY

R. Alexander

